


Revisions	Date	Issue	Description
08-29-2011	A	ISSUED FOR CLIENT'S REVIEW	
10-31-2011	B	ISSUED FOR 30% COST ESTIMATION	
11-15-2011	C	FOR 100% SITE PREPARATION CLIENT'S REVIEW	
02-17-2012	D	FOR HUDSON-ESSEX-PASSAIC SOIL CONSERVATION DISTRICT FILING AND APPROVAL	
09-31-2012	E	ISSUED TO DCA FOR REVIEW	
09-18-2012	F	ISSUED FOR CONTRACTOR BIDDING	

5706m  
Rim 447.50  
2m West - 441.50  
2m North - 445.27

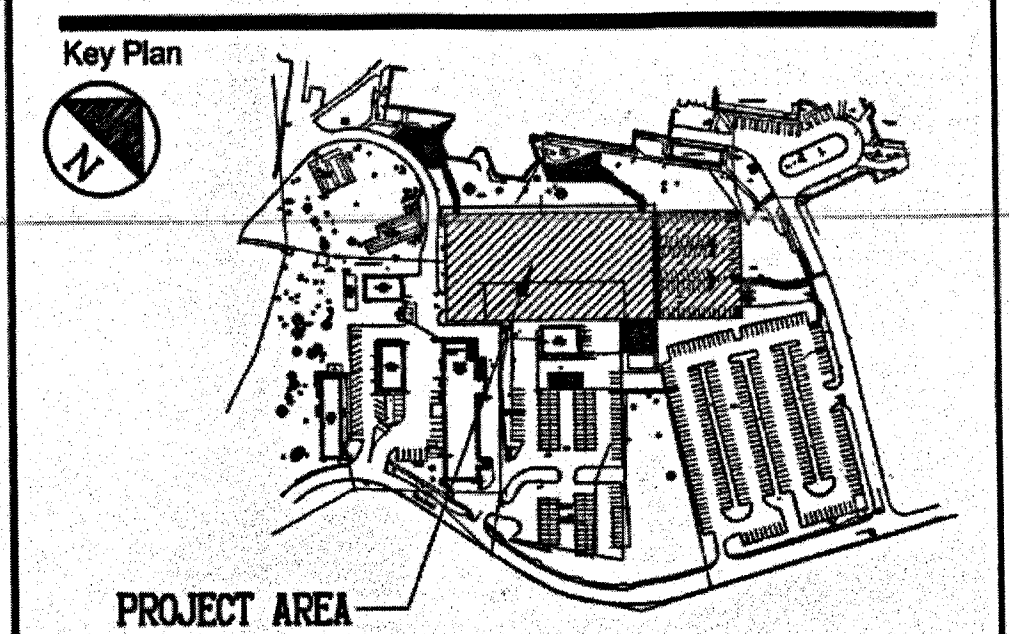

**WALKER**  
PARKING CONSULTANTS

**sanitary**  
**storm**  
**water**

**Consultants**

**TMG**  
Engineering  
Inc.

Consulting Mechanical and Electrical Engineers  
1090 King George Post Rd.  
Suite No. 803  
Edison, New Jersey 08837  
Phone: 732-736-9570  
Fax: 732-736-9572  
New Jersey Certificate of Authorization  
Number: 246A25081900

FRANK G. RADOSIN N.J.E.E. 33923  
TMG JOB NUMBER 00-000

**Project**

**New Parking Garage**  
at  
**William Paterson University**  
East Road Parking Lot 1  
Wayne, New Jersey 07470  
Project # WP-10-03-99A

**Site Preparation**

**William Paterson University**  
Office of Capital Planning,  
Design & Construction

300 Pompton Road  
Wayne, New Jersey 07470

**SNS** Architects & Engineers, PC

1 PARAGON DRIVE • MONTVALE • NEW JERSEY, 07845  
TEL: 201.578.1787 FAX: 201.578.0808 www.sns-arch.com

Fay W. Logan, AA  
John M. Lignos, AA  
Lorin J. Sonnenshine, AA  
Steven Napolitano, PE, PP, LEED AP

Cert./Lic. No. 41998  
Date 08-28-11 Scale AS NOTED

Drawn By AS Checked By

Dwg. Title **SITE PLAN - AS BUILT**  
**UTILITIES PLAN**

**4242** **Y-5**

**CONTRACTOR SHALL COORDINATE ALL GAS, WATER & ELEC. UTILITIES REQUIREMENTS WITH RESPECTIVE UTILITY CO. PRIOR TO CONSTRUCTION & SHALL INCLUDE ALL NECESSARY WORK IN THEIR CONSTRUCTION BID.**

**CONTRACTOR SHALL INCLUDE IN THEIR BID PRICE TO OBTAIN THE SERVICES OF A LICENSED SURVEYOR IN THE STATE OF NEW JERSEY TO PROVIDE AS TO VERIFY ALL EXISTING UTILITIES, ABOVE GROUND AND BELOW GROUND, PRIOR TO CONSTRUCTION. FURTHERMORE CONTRACTOR SHALL FURNISH THIS SURVEY TO THE ARCHITECT/ENGINEER AND OWNER FOR THEIR USE AND REVIEW.**

**SITE DATUM ELEV. 412.0' = 0'-0" (REFERENCE ELEVATION)**